


1 Basement Floor Plan

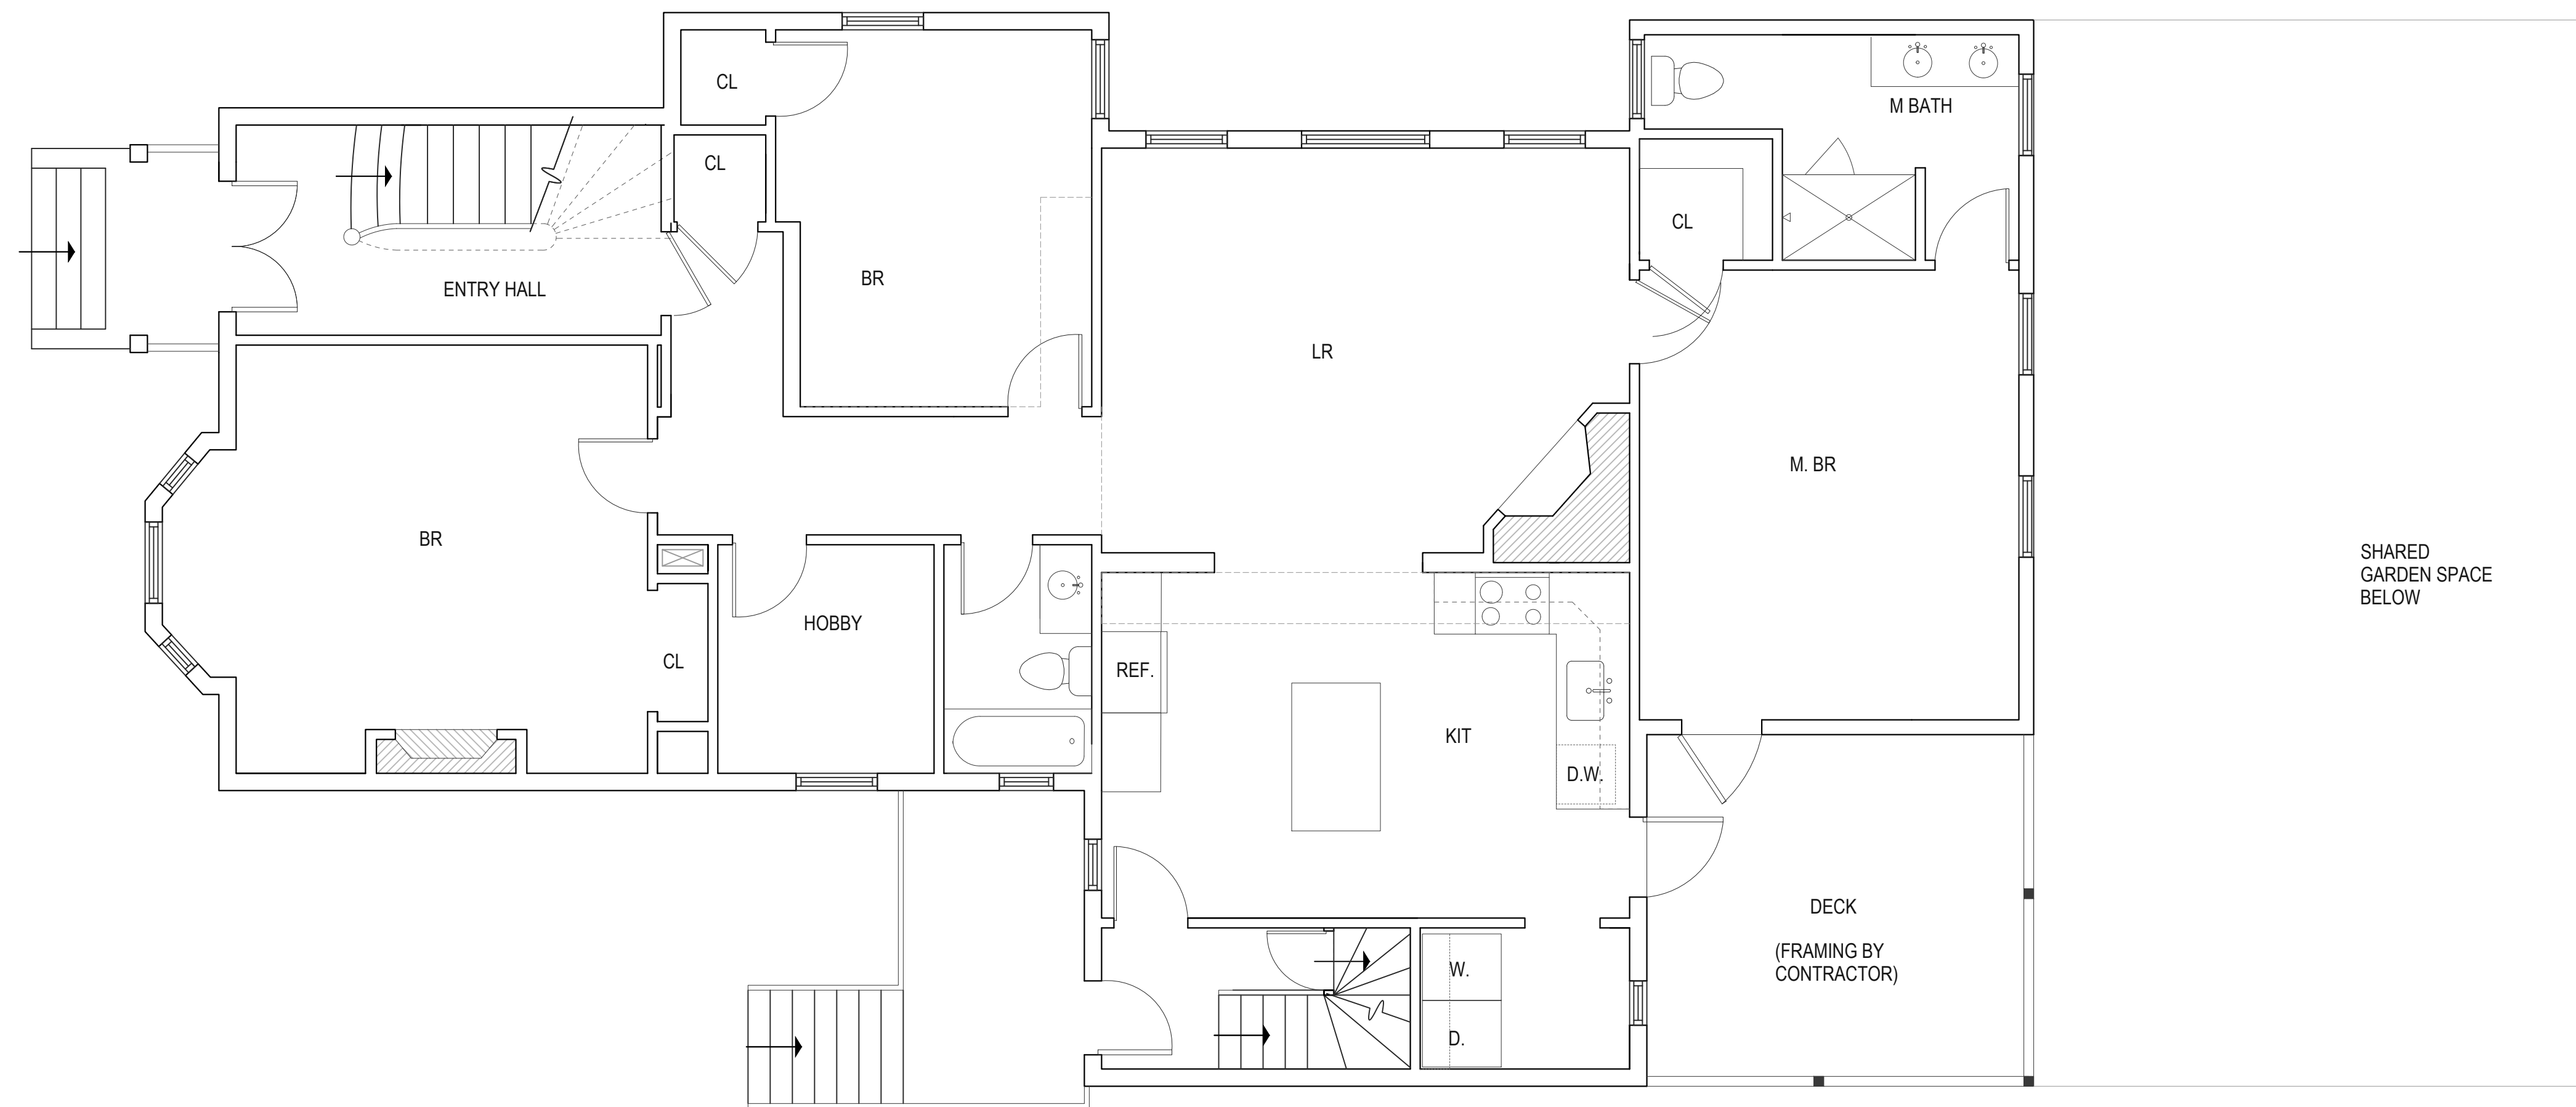

2 First Floor Plan

As-Built Record Drawing

No.	Description	Date
1	PERMITS	6/30/17
2	AS BUILT	4/25/18
3	AS BUILT - EDITS	5/30/18
4	AS BUILT - EDITS	6/25/18
5	UPDATE BASEMENT	9/17/18

**63 MONMOUTH ST
EAST BOSTON**

**Basement & First
As built Floor Plans**

Project number 15-021
Date 6/30/2017
Drawn by EL
Checked by DE